SPECIFIC CONSTRUCTION NOTES:

NUMBERS ABOVE 100 SHOWN IN ⬡ ON THE PLAN REFER TO THE RESPECTIVE STANDARD DRAWING NUMBERS AND SHALL BE CONSTRUCTED ACCORDINGLY UNLESS MODIFICATIONS ARE NOTED ON THE PLAN. ANY NUMBER SHOWN BELOW THE STANDARD DRAWING INDICATES THE SPECIFIC ALTERNATE TO BE CONSTRUCTED.

GENERAL CONSTRUCTION NOTES:

1. UTILITIES SHOWN IN CONFLICT WITH PROPOSED STORM DRAIN FACILITIES WILL BE RELOCATED PRIOR TO CONSTRUCTION.
2. EXISTING UTILITIES SHOWN ON THIS PLAN, ARE PLOTTED FROM UTILITY RECORDS. THE CONTRACTOR IS REQUIRED TO TAKE DUE PRECAUTIONARY MEASURES TO LOCATE AND PROTECT ALL UTILITIES WHETHER OR NOT SHOWN ON THIS PLAN. IF THE COVER OF A UTILITY IS KNOWN IT IS SHOWN IN THE PROFILE. UTILITIES SHOWN IN THE PROFILE AS ┤ INDICATES THAT COVER IS UNKNOWN, BUT THE UTILITY IS NOT EXPECTED TO CONFLICT WITH THE PROPOSED IMPROVEMENTS.

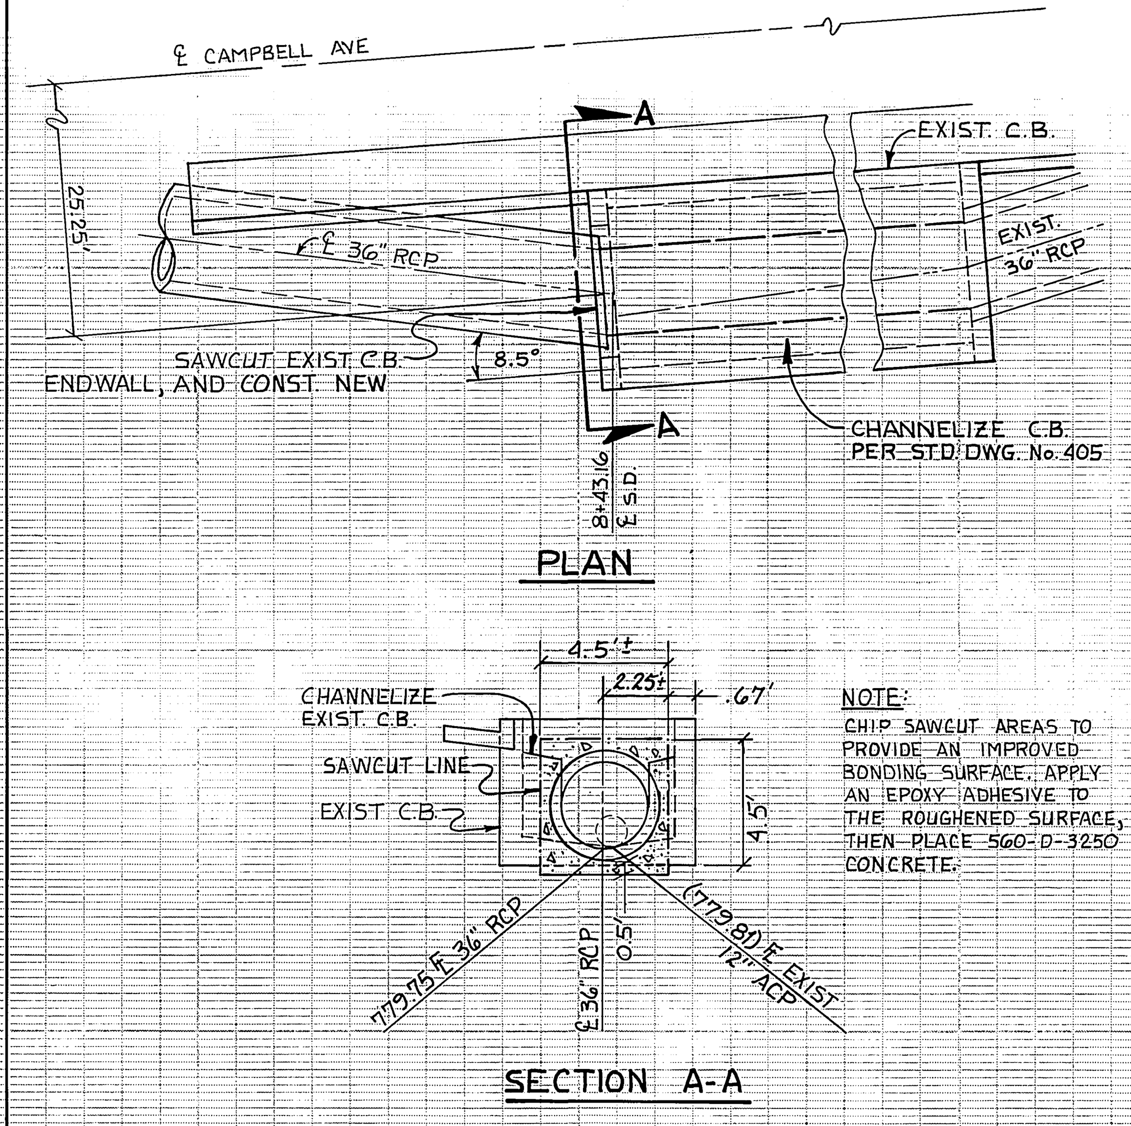

STORM DRAIN CONNECTION DETAIL

NO SCALE

STATION 8+43

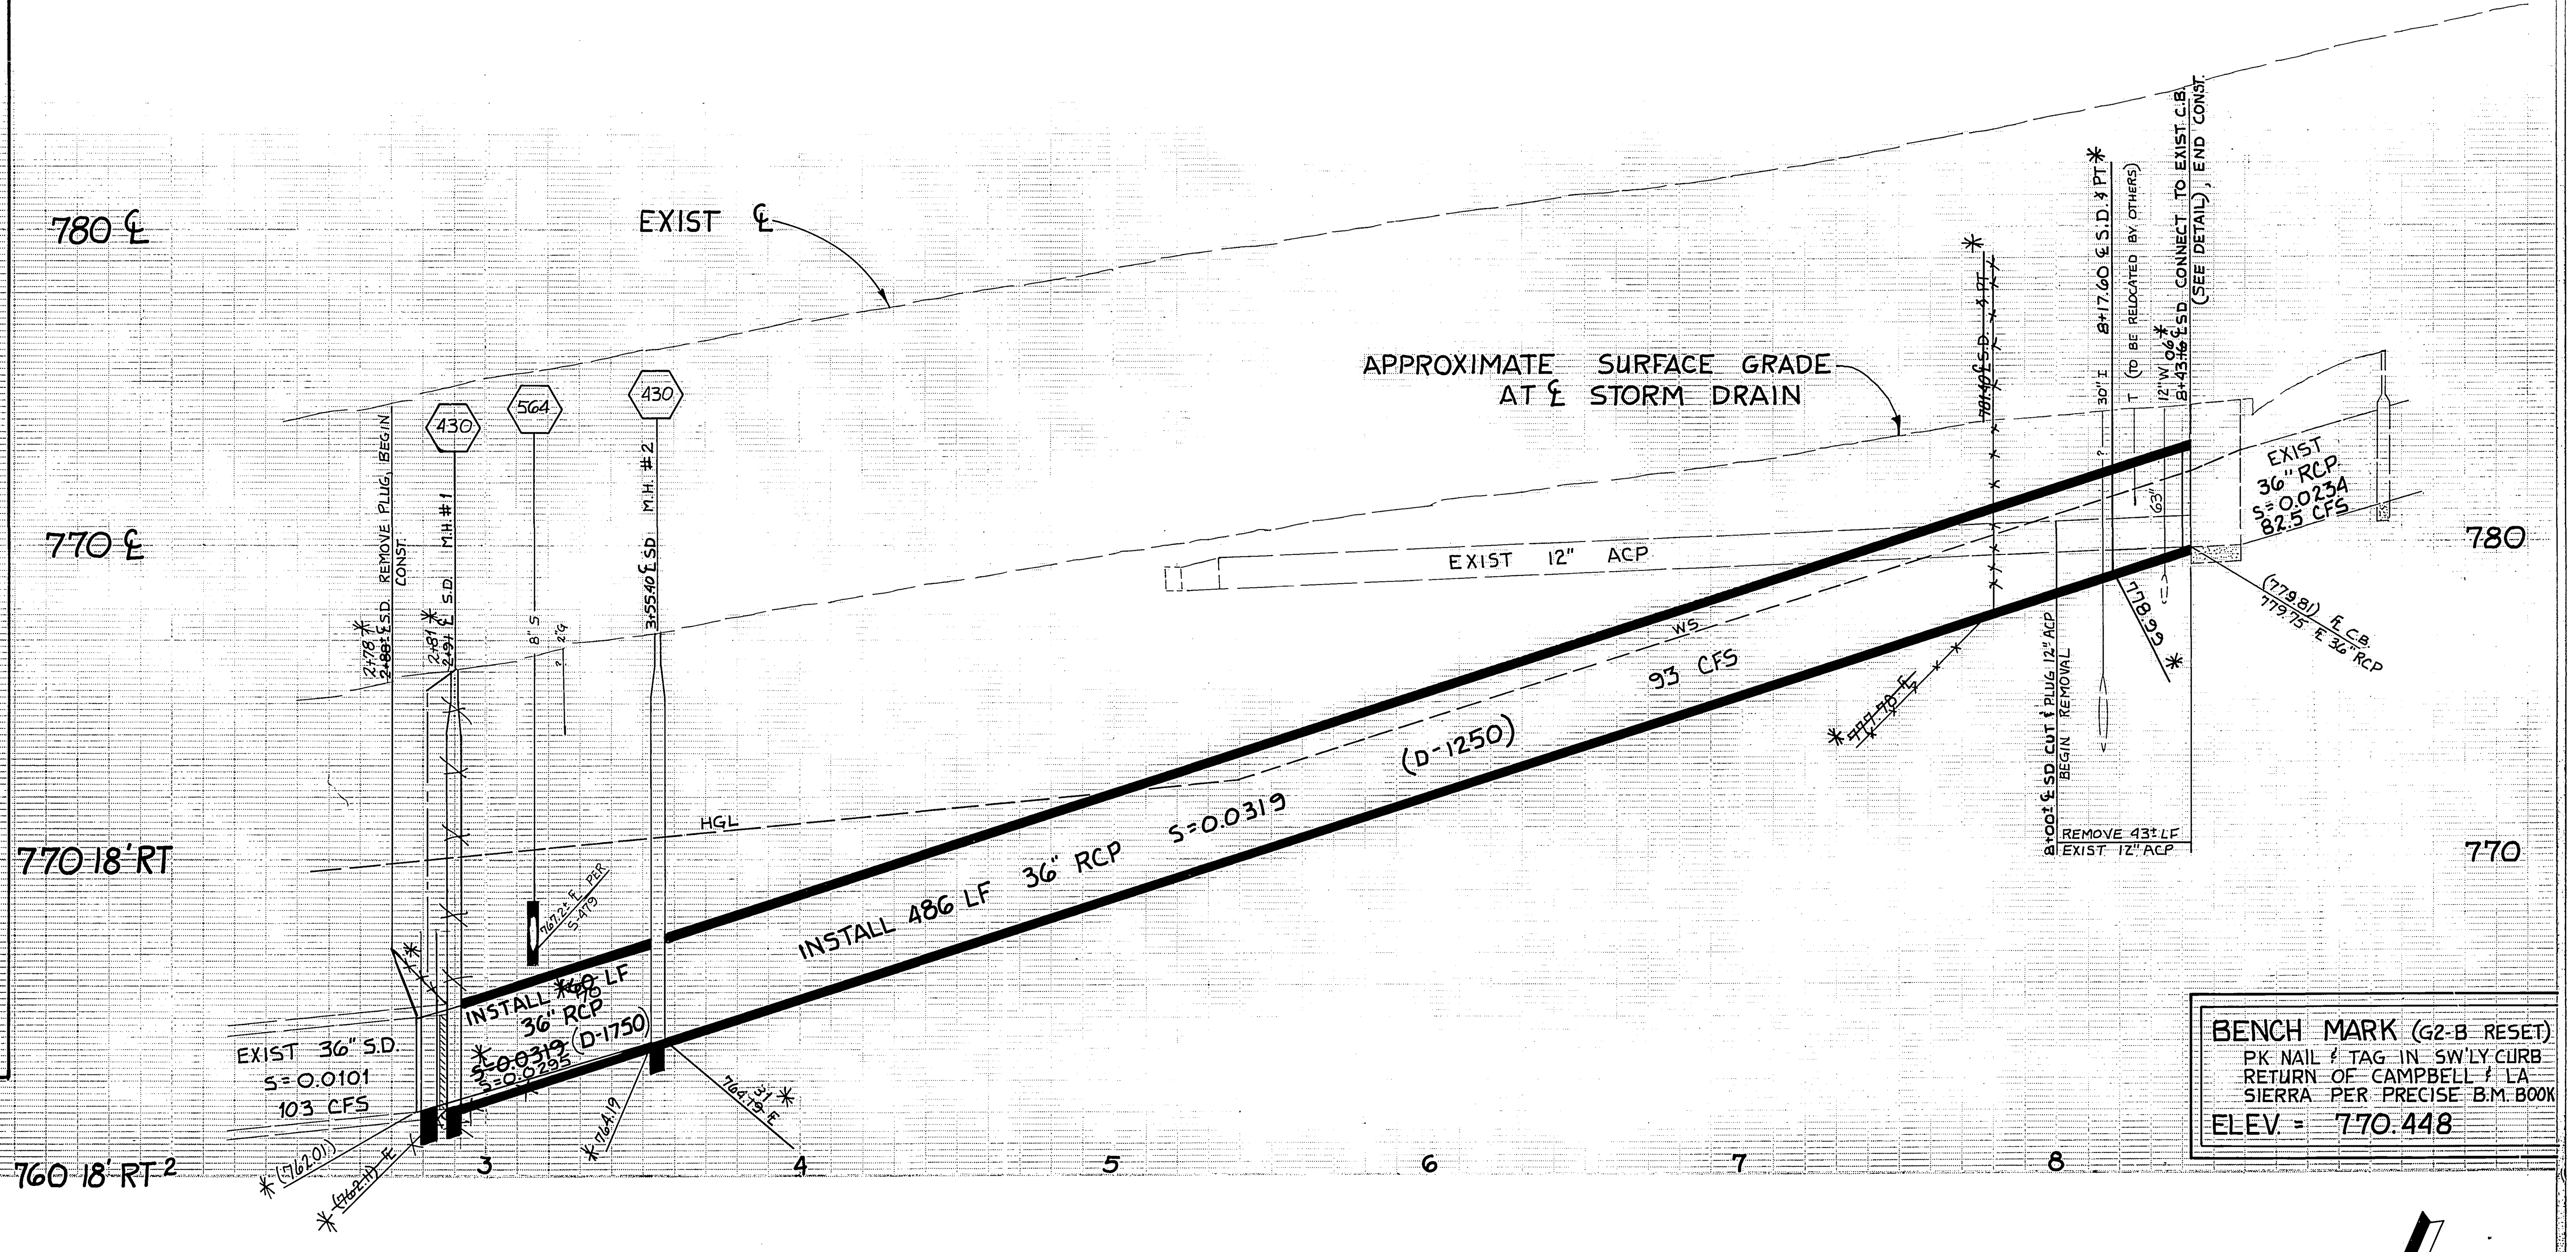

BENCH MARK (G2-B RESET)

PK NAIL & TAG IN SW'LY CURB RETURN OF CAMPBELL & LA SIERRA PER PRECISE B.M. BOOK

ELEV. = 770.448

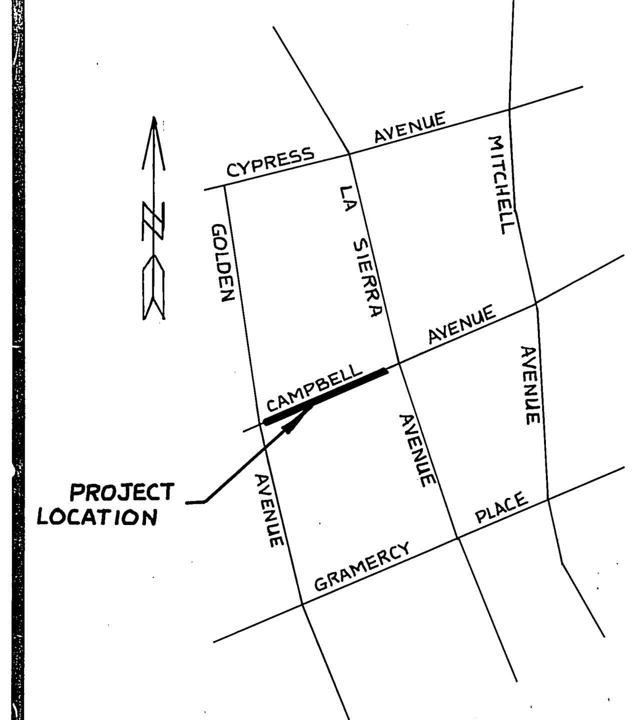

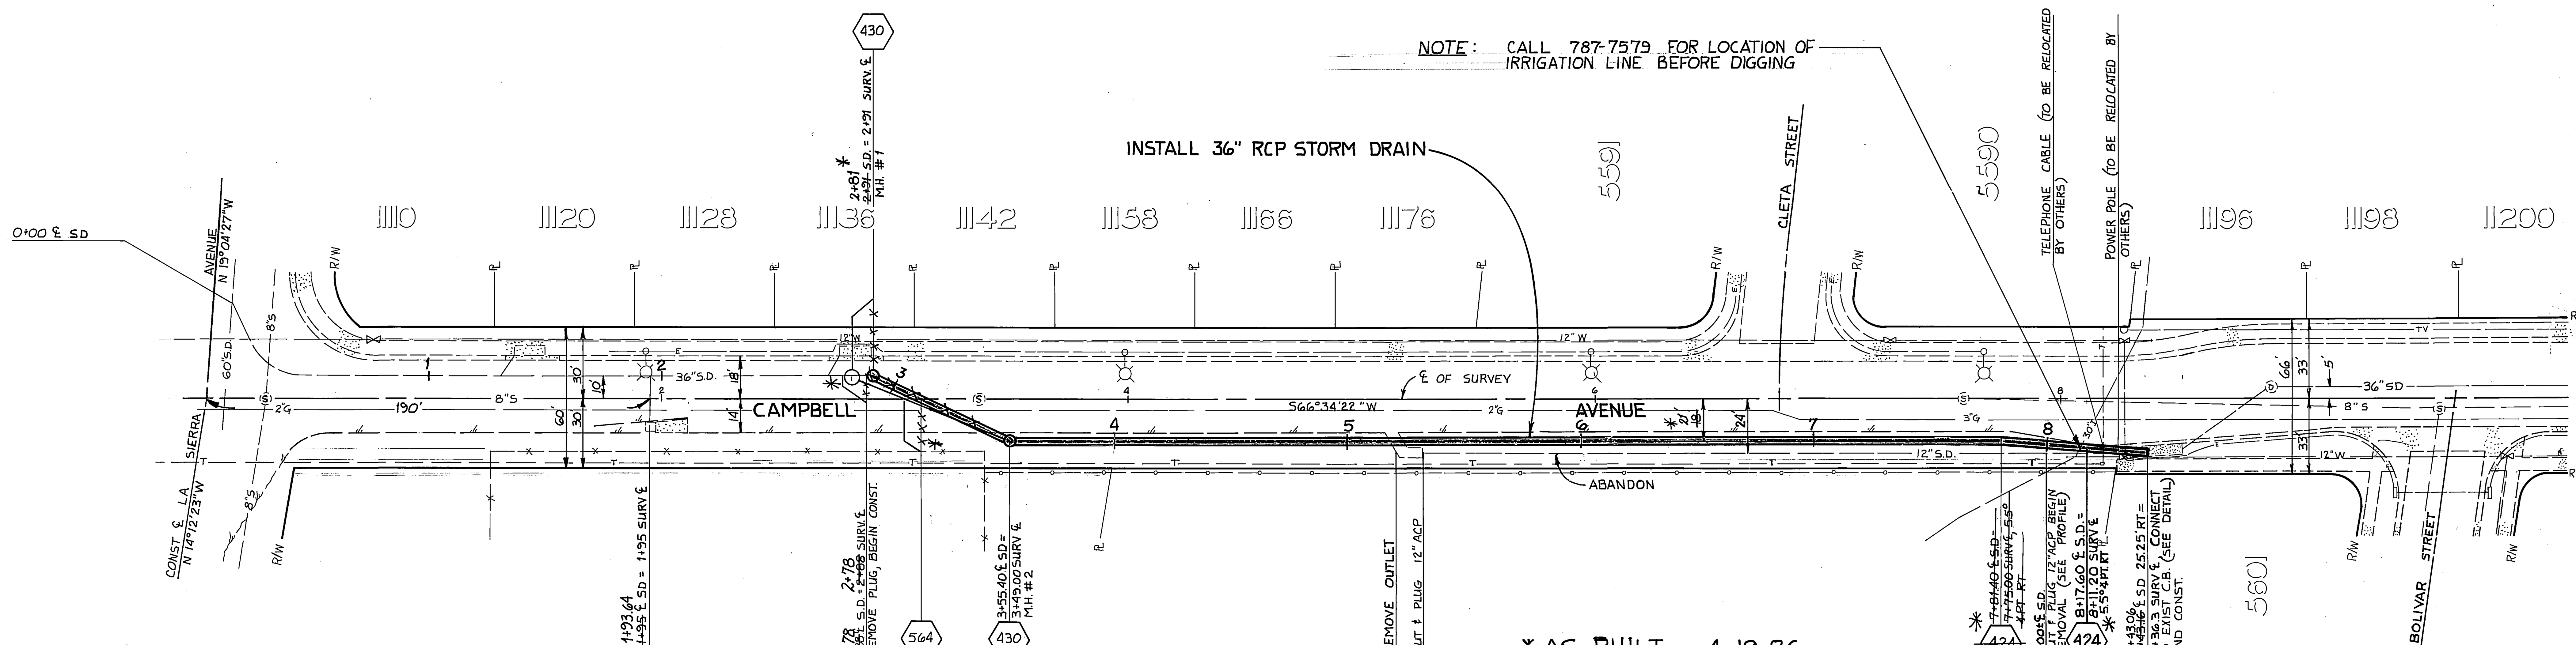

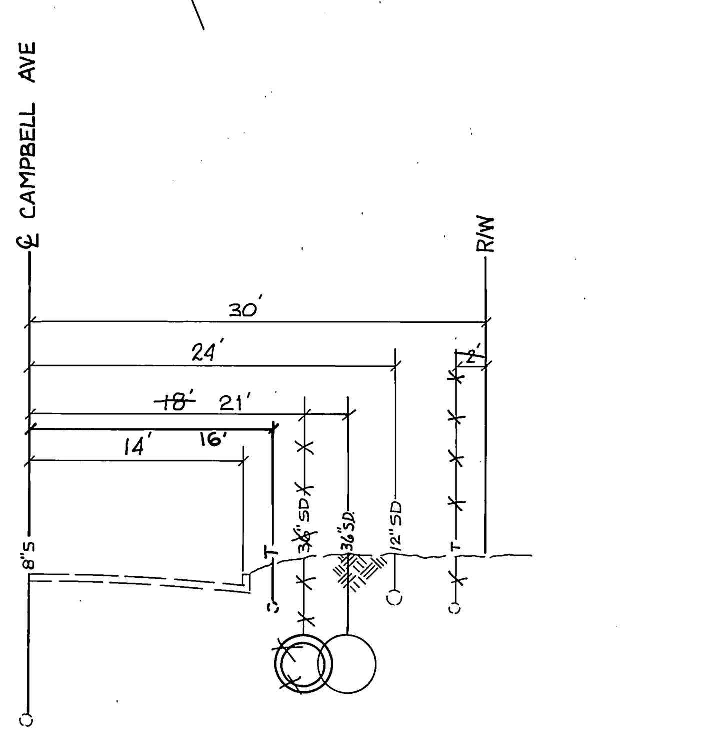

TYPICAL SECTION

STA. 5+20 TO STA. 7+81.40 SCALE: HOR: 1"=10', VERT: 1"=10'

*AS BUILT 4-19-86 BLD

INDEXED BY C.S.

MARK	REVISIONS	APPR.	DATE

DESIGNED BY BLD DRAWN BY BLD CHECKED BY SC

CITY OF RIVERSIDE
PUBLIC WORKS DEPARTMENT

APPROVED BY	DATE	BY
PRINCIPAL ENGINEER	[signature]	5-7-85
PARK DEPARTMENT	—	—
TRAFFIC DIVISION	—	—
CHIEF P. W. ENGINEER		

APPROVED BY William D. Gardner
PUBLIC WORKS DIRECTOR
DATE May 28, 1985

CAMPBELL AVENUE STORM DRAIN IMPROVEMENT

LA SIERRA AVE TO BOLIVAR ST

HORIZ. SCALE: 1" = 40' VERT. SCALE: 1" = 4'

ACCOUNT NO. 09-573-404

D-469

SHEET 1 OF 1